


XLH05D-001-2016

PLANOS ELÉCTRICOS



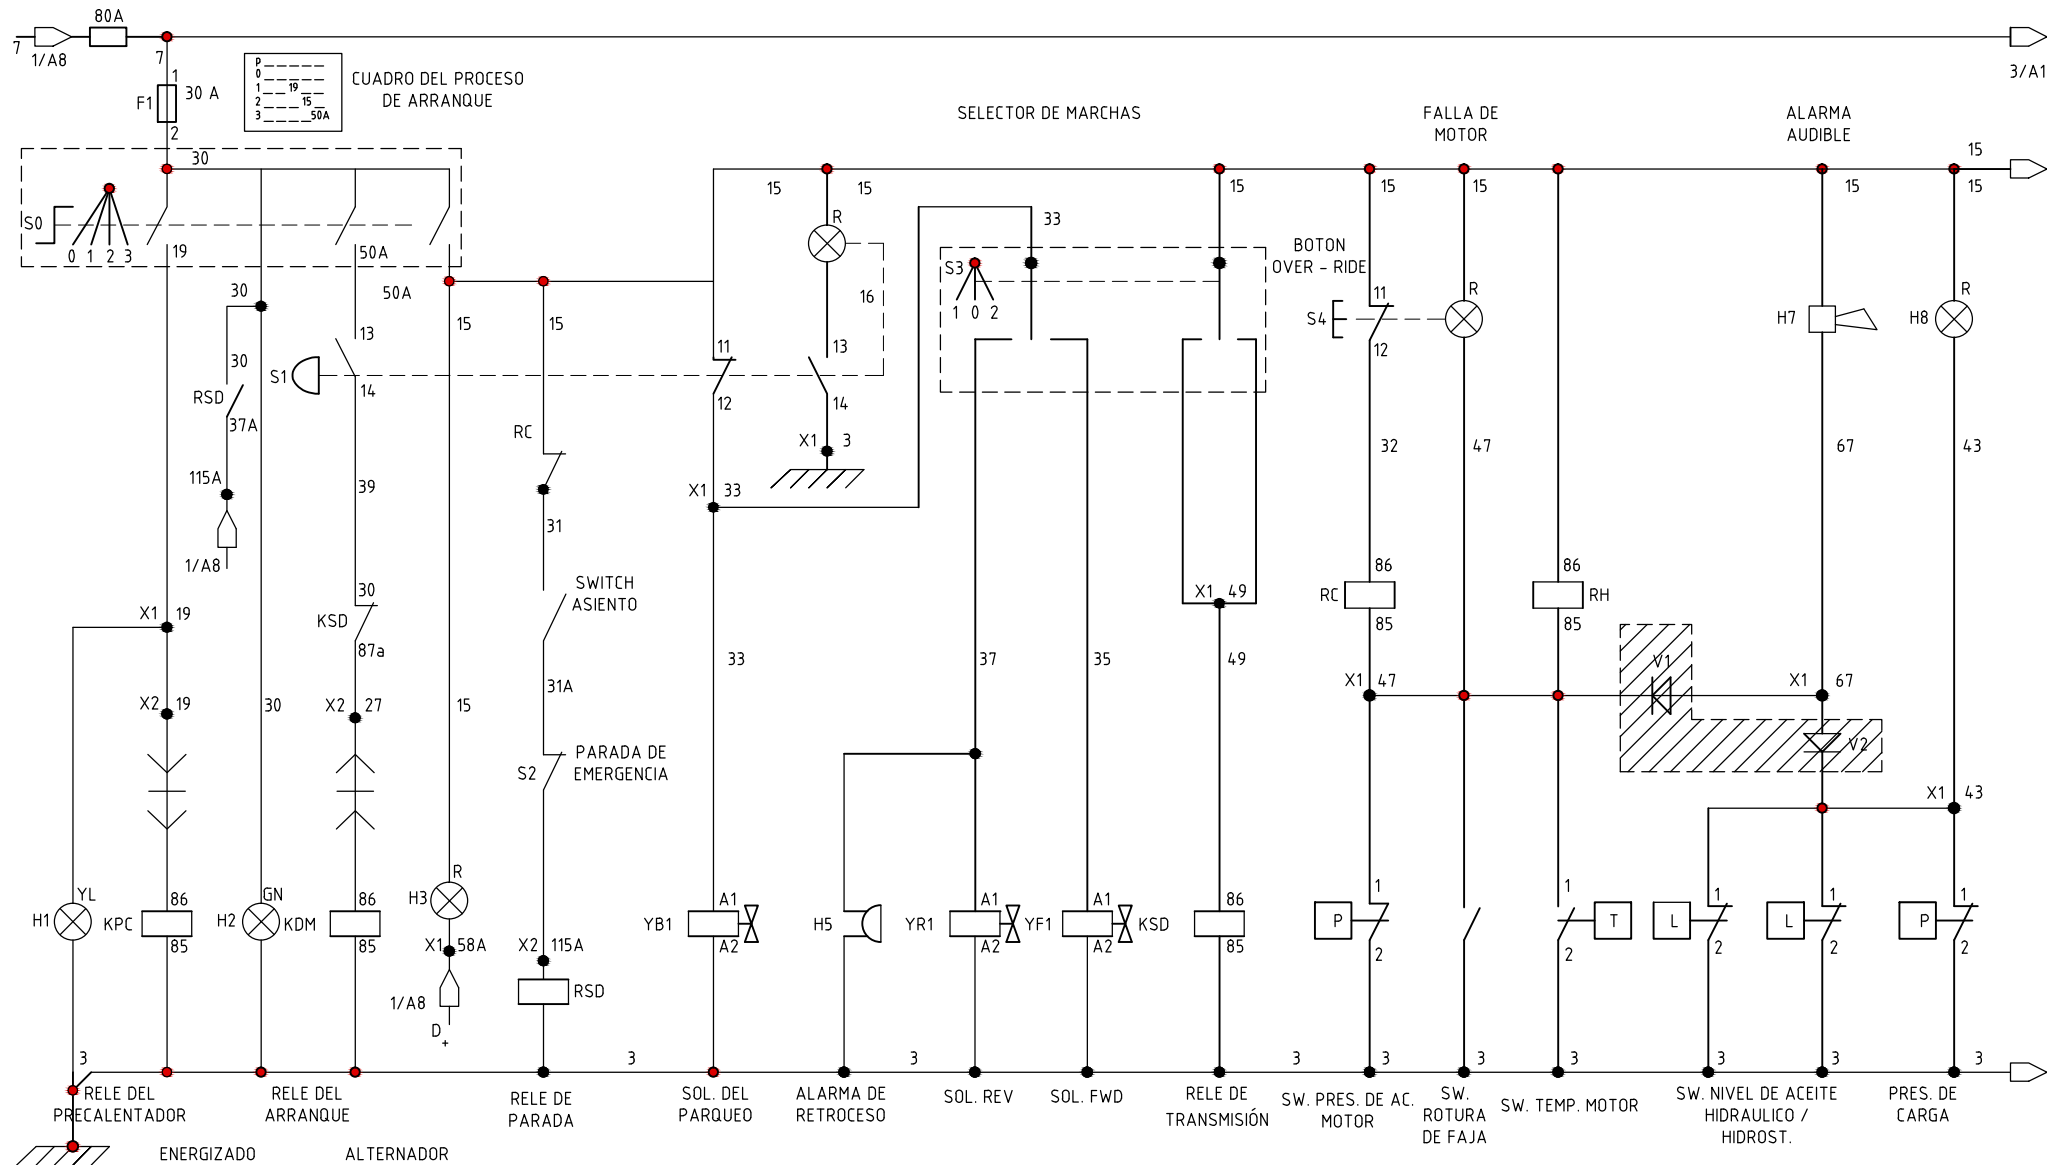

OVERPRIME

AS BUILT

EMITIDO PARA APROBACION


REV	DESCRIPTION	DATE	BY


DRAWN BY:	CARLOS CHAVEZ
VERIFIED BY:	JHON HUAMANI
APPROVED BY:	MARCIO VILCAPOMA
SCALE:	DATE: 01/08/2016
PROJECT No.: FEI-0040	DWG: DIAGRAMA ELECTRICO XLH05D .DWG

MICROSCOOP XLH05D

DIAGRAMA ELECTRICO XLH05D

DRAWING No. DWG_001	REVISION 0	PAGE: 2 CONT. 3
---------------------	------------	-----------------

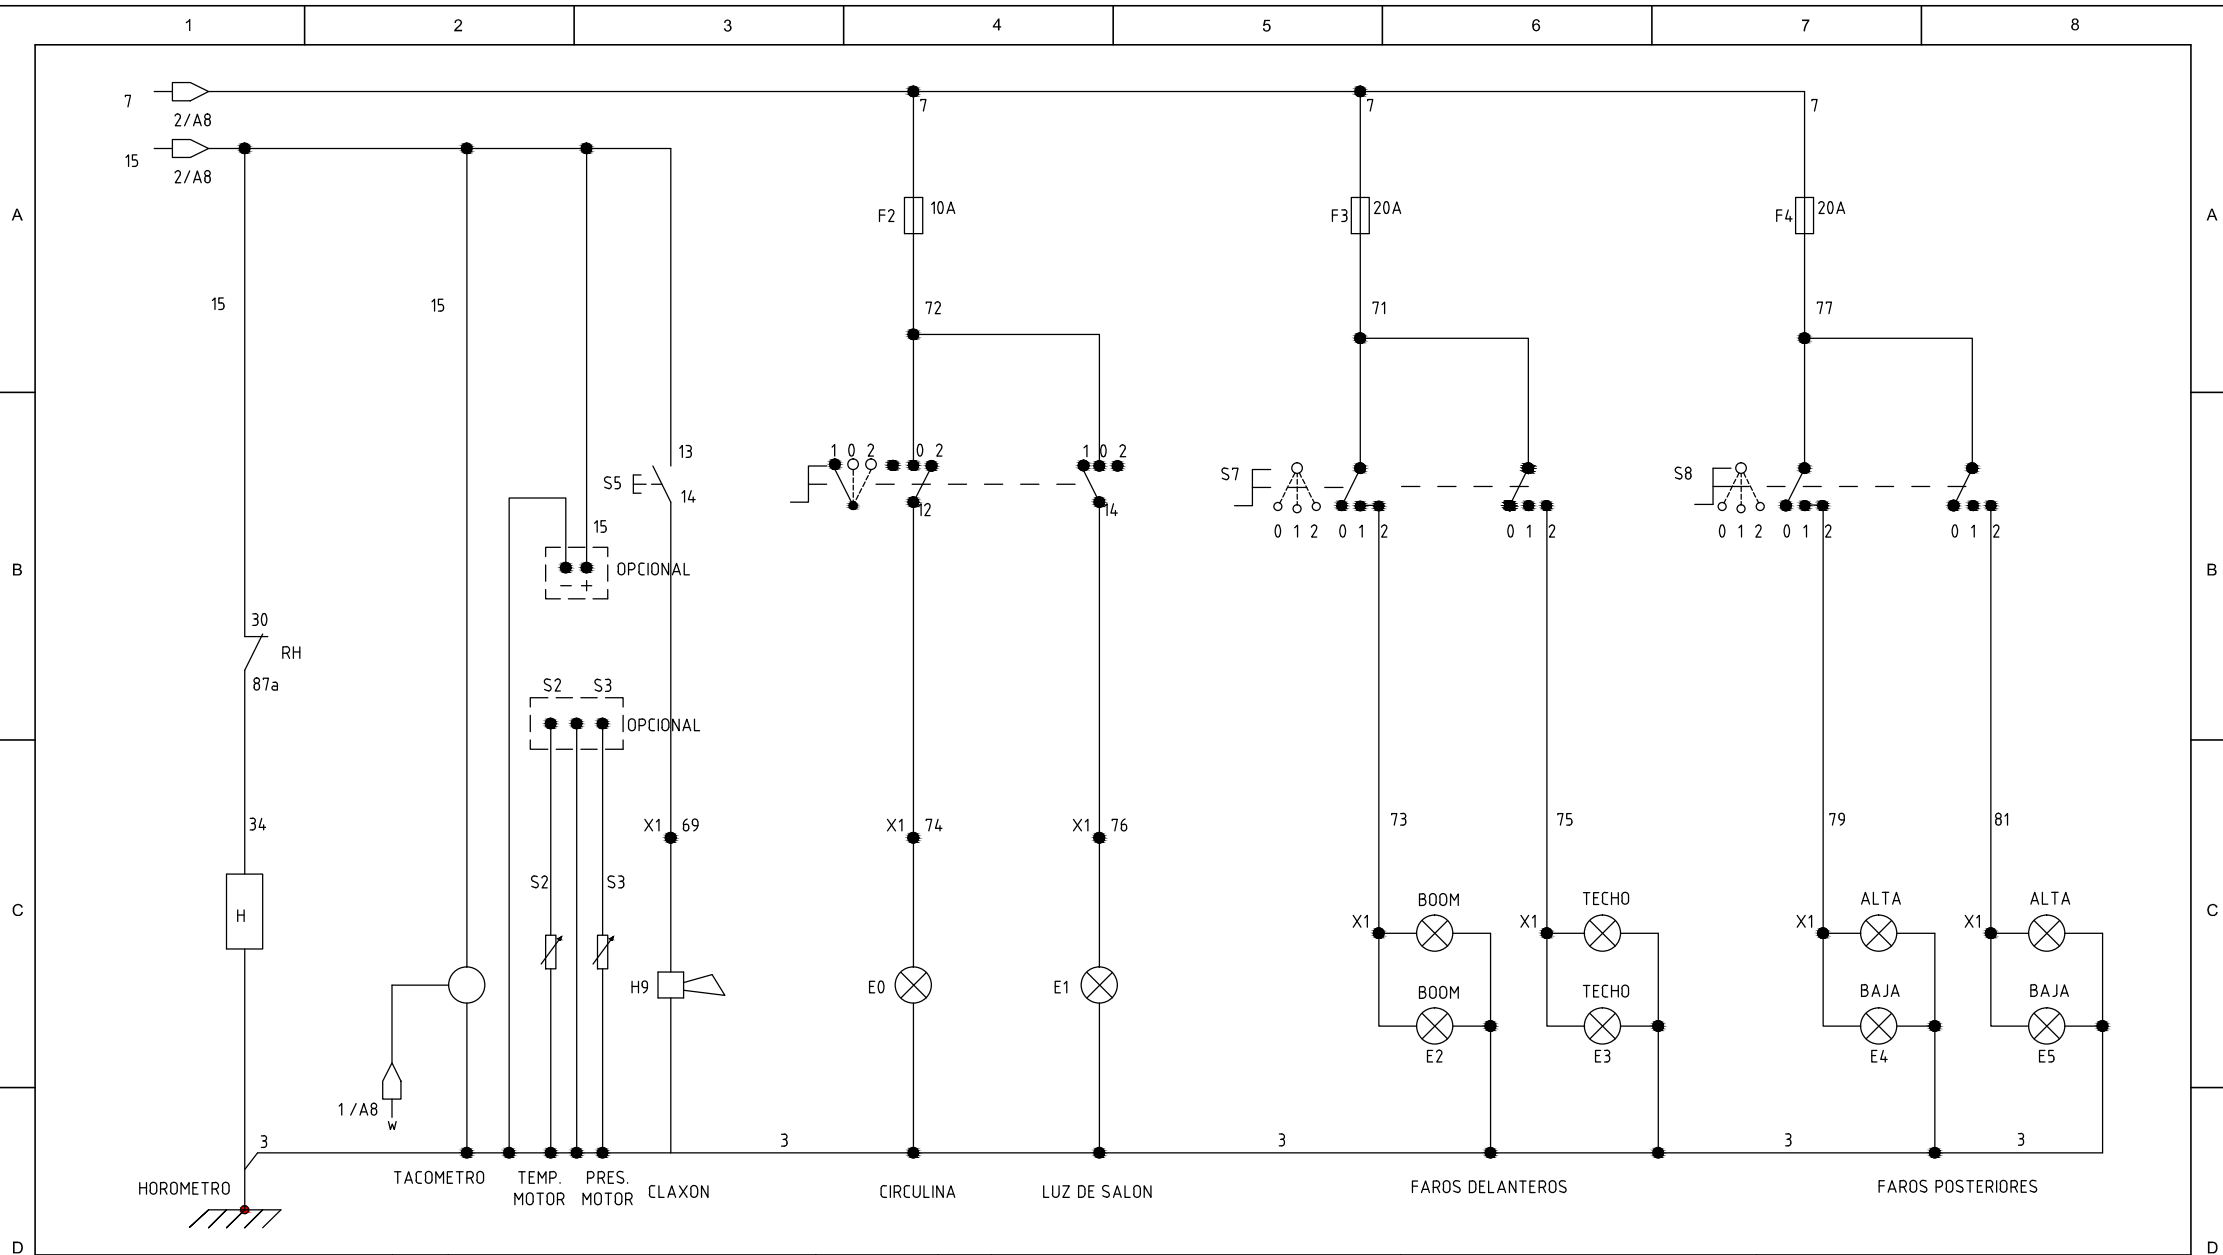

					OVERPRIME	DRAWN BY: CARLOS CHAVEZ		MICROSCOOP XLH05D		
						VERIFIED BY: JHON HUAMANI				
						APPROVED BY: MARCIO VILCAPOMA		DIAGRAMA ELECTRICO XLH05D		
			AS BUILT				SCALE: none			
		EMITIDO PARA APROBACION								
REV	DESCRIPTION		DATE	BY	NOTAS	PROJECT No.: FEI-0040	DWG: DIAGRAMA ELECTRICO XLH05D .DWG	DRAWING No. DWG_001	REVISION 0	PAGE: 3 CONT: 3