


2016

# MANUAL DE PARTES CONTROL REMOTO MINI LOADER XLH05D



## CONTROL REMOTO XLH05D

COD. 140750493-001

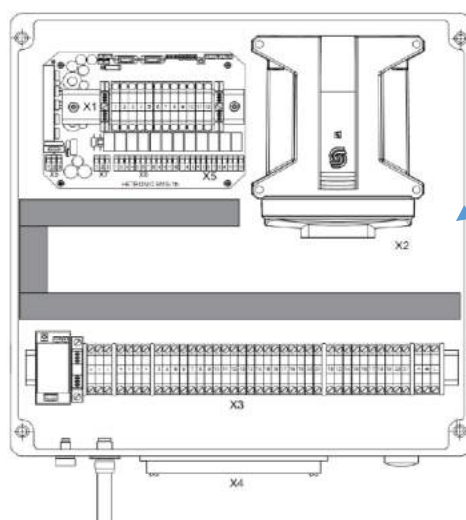


## CONTROL REMOTO XLH05D

**COD. 140750493-001**

ID	CODIGO	DESCRIPCION	CANT.
1	140720495-002	TRANSMISOR DE CONTROL REMOTO XLH05D	1
2	140720495-003	RECEPTOR DE CONTROL REMOTO-XLH05D	1
3	140720493-024	BATERIA DE CONTROL REMOTO-XLH05D	1

## DIAGRAMA DE PARTES RECEPTOR XLH05D

COD. 140720495-003

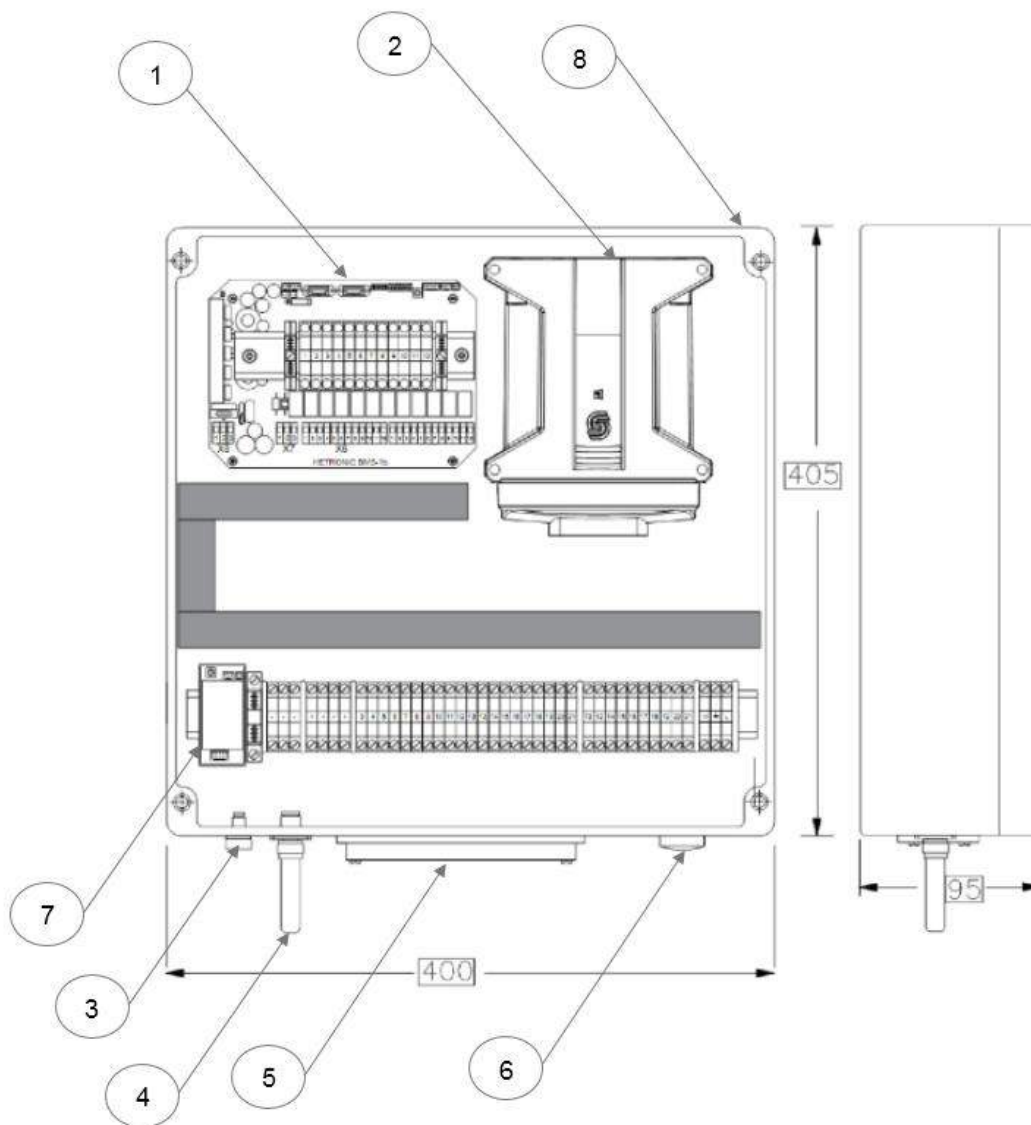

## RECEPTOR DE CONTROL REMOTO XLH05D

**COD. 140720495-003**

ID	CODIGO	DESCRIPCION	CANT.
1	140720493-004	PLACA DE CONTROL MBS-1B	1
2	140720493-005	MICROCONTROLADOR MC050-110	1
3	140720493-006	PULSADOR	1
4	140720493-007	ANTENA TNC	1
5	140720493-008	CONECTOR MACHO	1
6	140720493-009	CONECTOR	1
7	140720493-010	MODULADOR DE ALTA FRECUENCIA	1
8	140720493-011	CUBIERTA DE RECEPTOR	1



## DIAGRAMA DE PARTES TRANSMISOR XLH05D


COD. 140720495-002




## TRANSMISOR DE CONTROL REMOTO XLH05D

**COD. 140720495-002**

ID	CODIGO	DESCRIPCION	CANT.
1	140720493-012	FAJA DE OPERADOR CONTROL	1
2	140720493-013	INTERRUPTOR DE INICIO/PARADA MOTOR	1
3	140720493-014	INTERRUPTOR DE LUZ ATRAS	1
4	140720493-015	INTERRUPTOR DE LUZ ADELANTE	1
5	140720493-016	INTERRUPTOR DE PARTIDA/PRECALENTADOR	1
6	140720493-017	INTERRUPTOR DE FRENADO	1
7	140720493-018	INTERRUPTOR DE TIPO PERILLA	1
8	140720493-019	PALANCA DE MANDO DIRECCION	1
9	140720493-020	PALANCA DE MANDO LEVANTE	1
10	140720493-021	LED BATERIA BAJA	1
11	140720493-022	LED NORMAL	1
12	140720493-023	BOTÓN DE PARADA EMERGENCIA	1

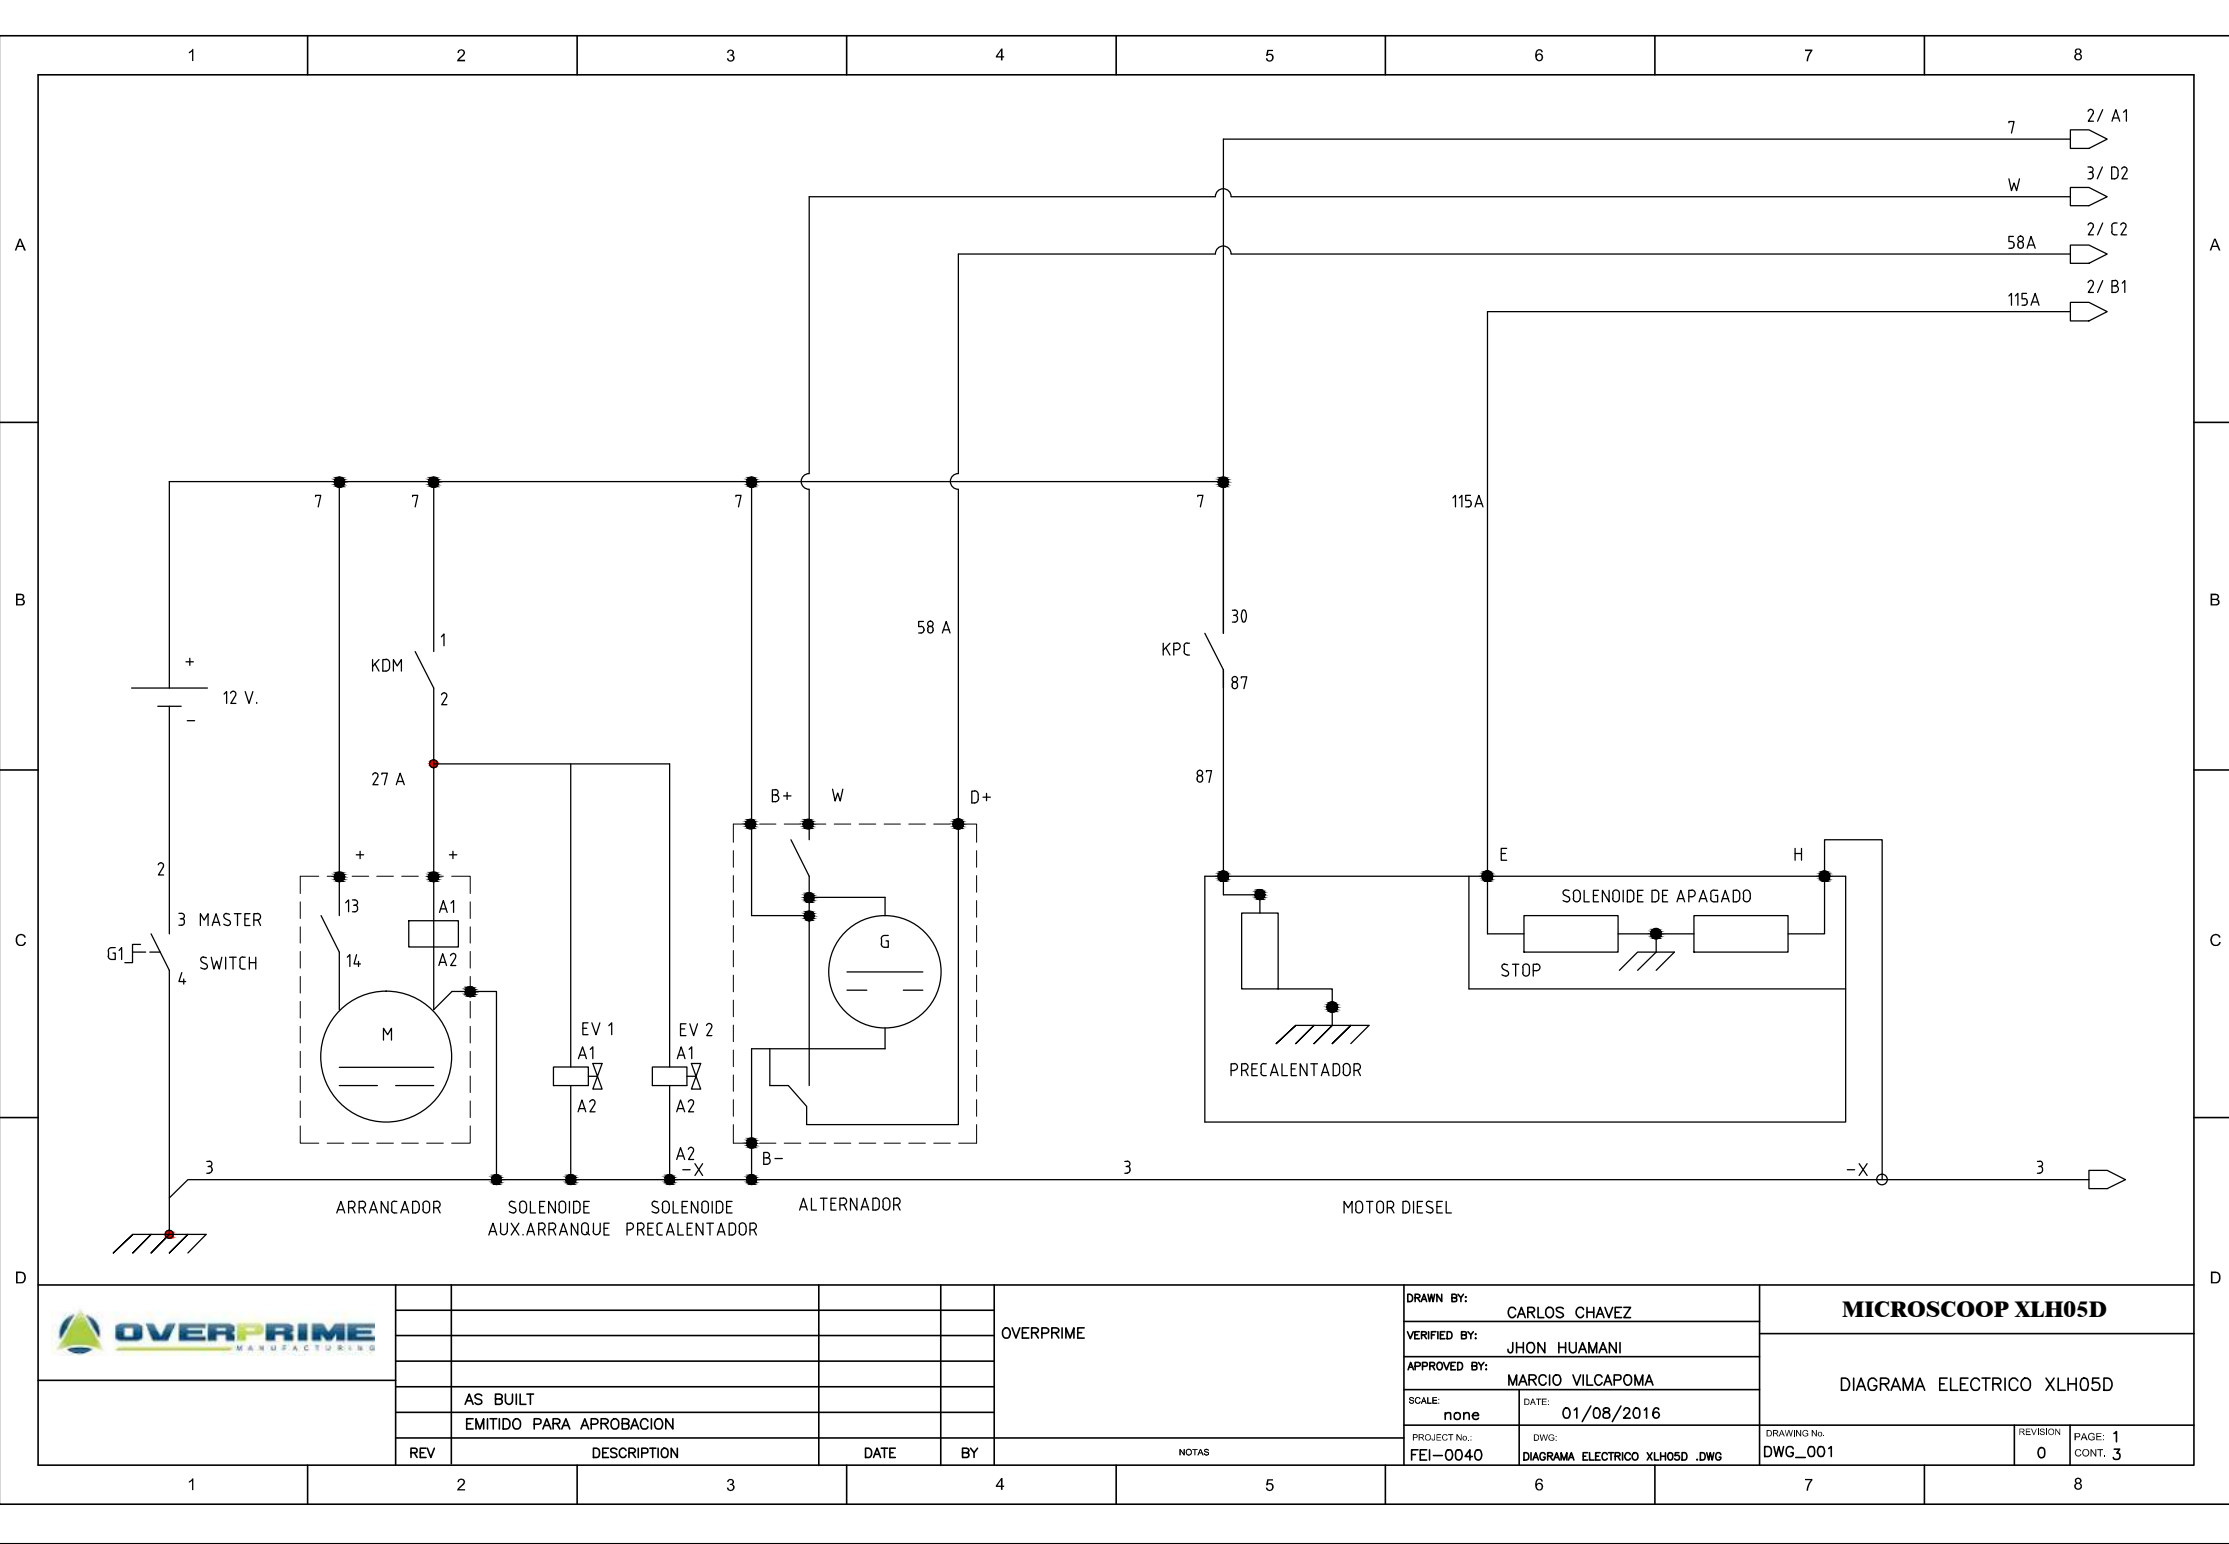



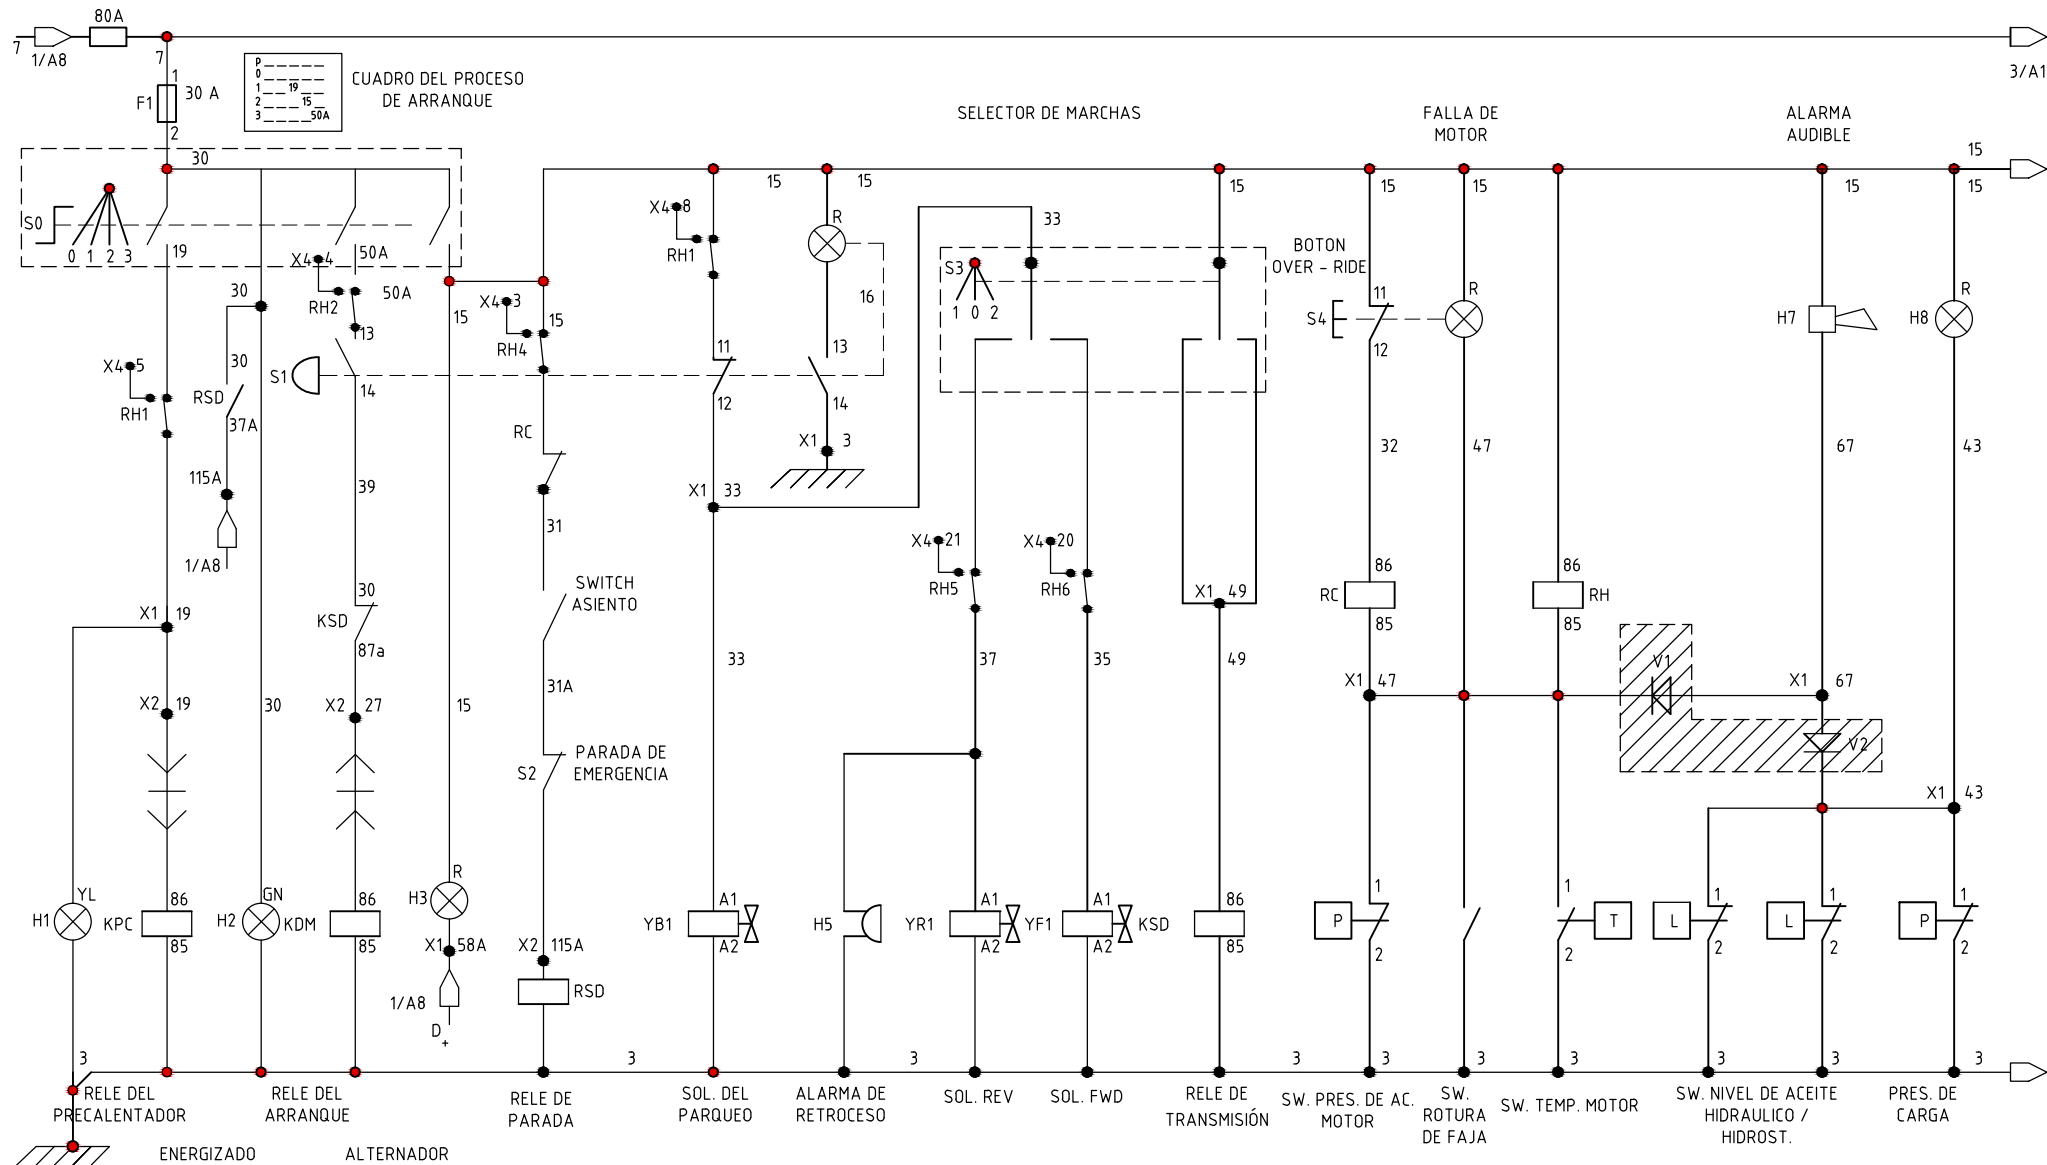

OVERPRIME

DRAWN BY: CARLOS CHAVEZ  
 VERIFIED BY: JHON HUAMANI  
 APPROVED BY: MARCIO VILCAPOMA  
 SCALE: none  
 DATE: 01/08/2016  
 PROJECT No.: FEI-0040  
 DWG: DIAGRAMA ELECTRICO XLH05D .DWG

**MICROSCOOP XLH05D**

DIAGRAMA ELECTRICO XLH05D


AS BUILT

EMITIDO PARA APROBACION

REV	DESCRIPTION	DATE	BY

NOTAS

DRAWING No.	REVISION	PAGE:
DWG_001	0	2
		CONT. 3

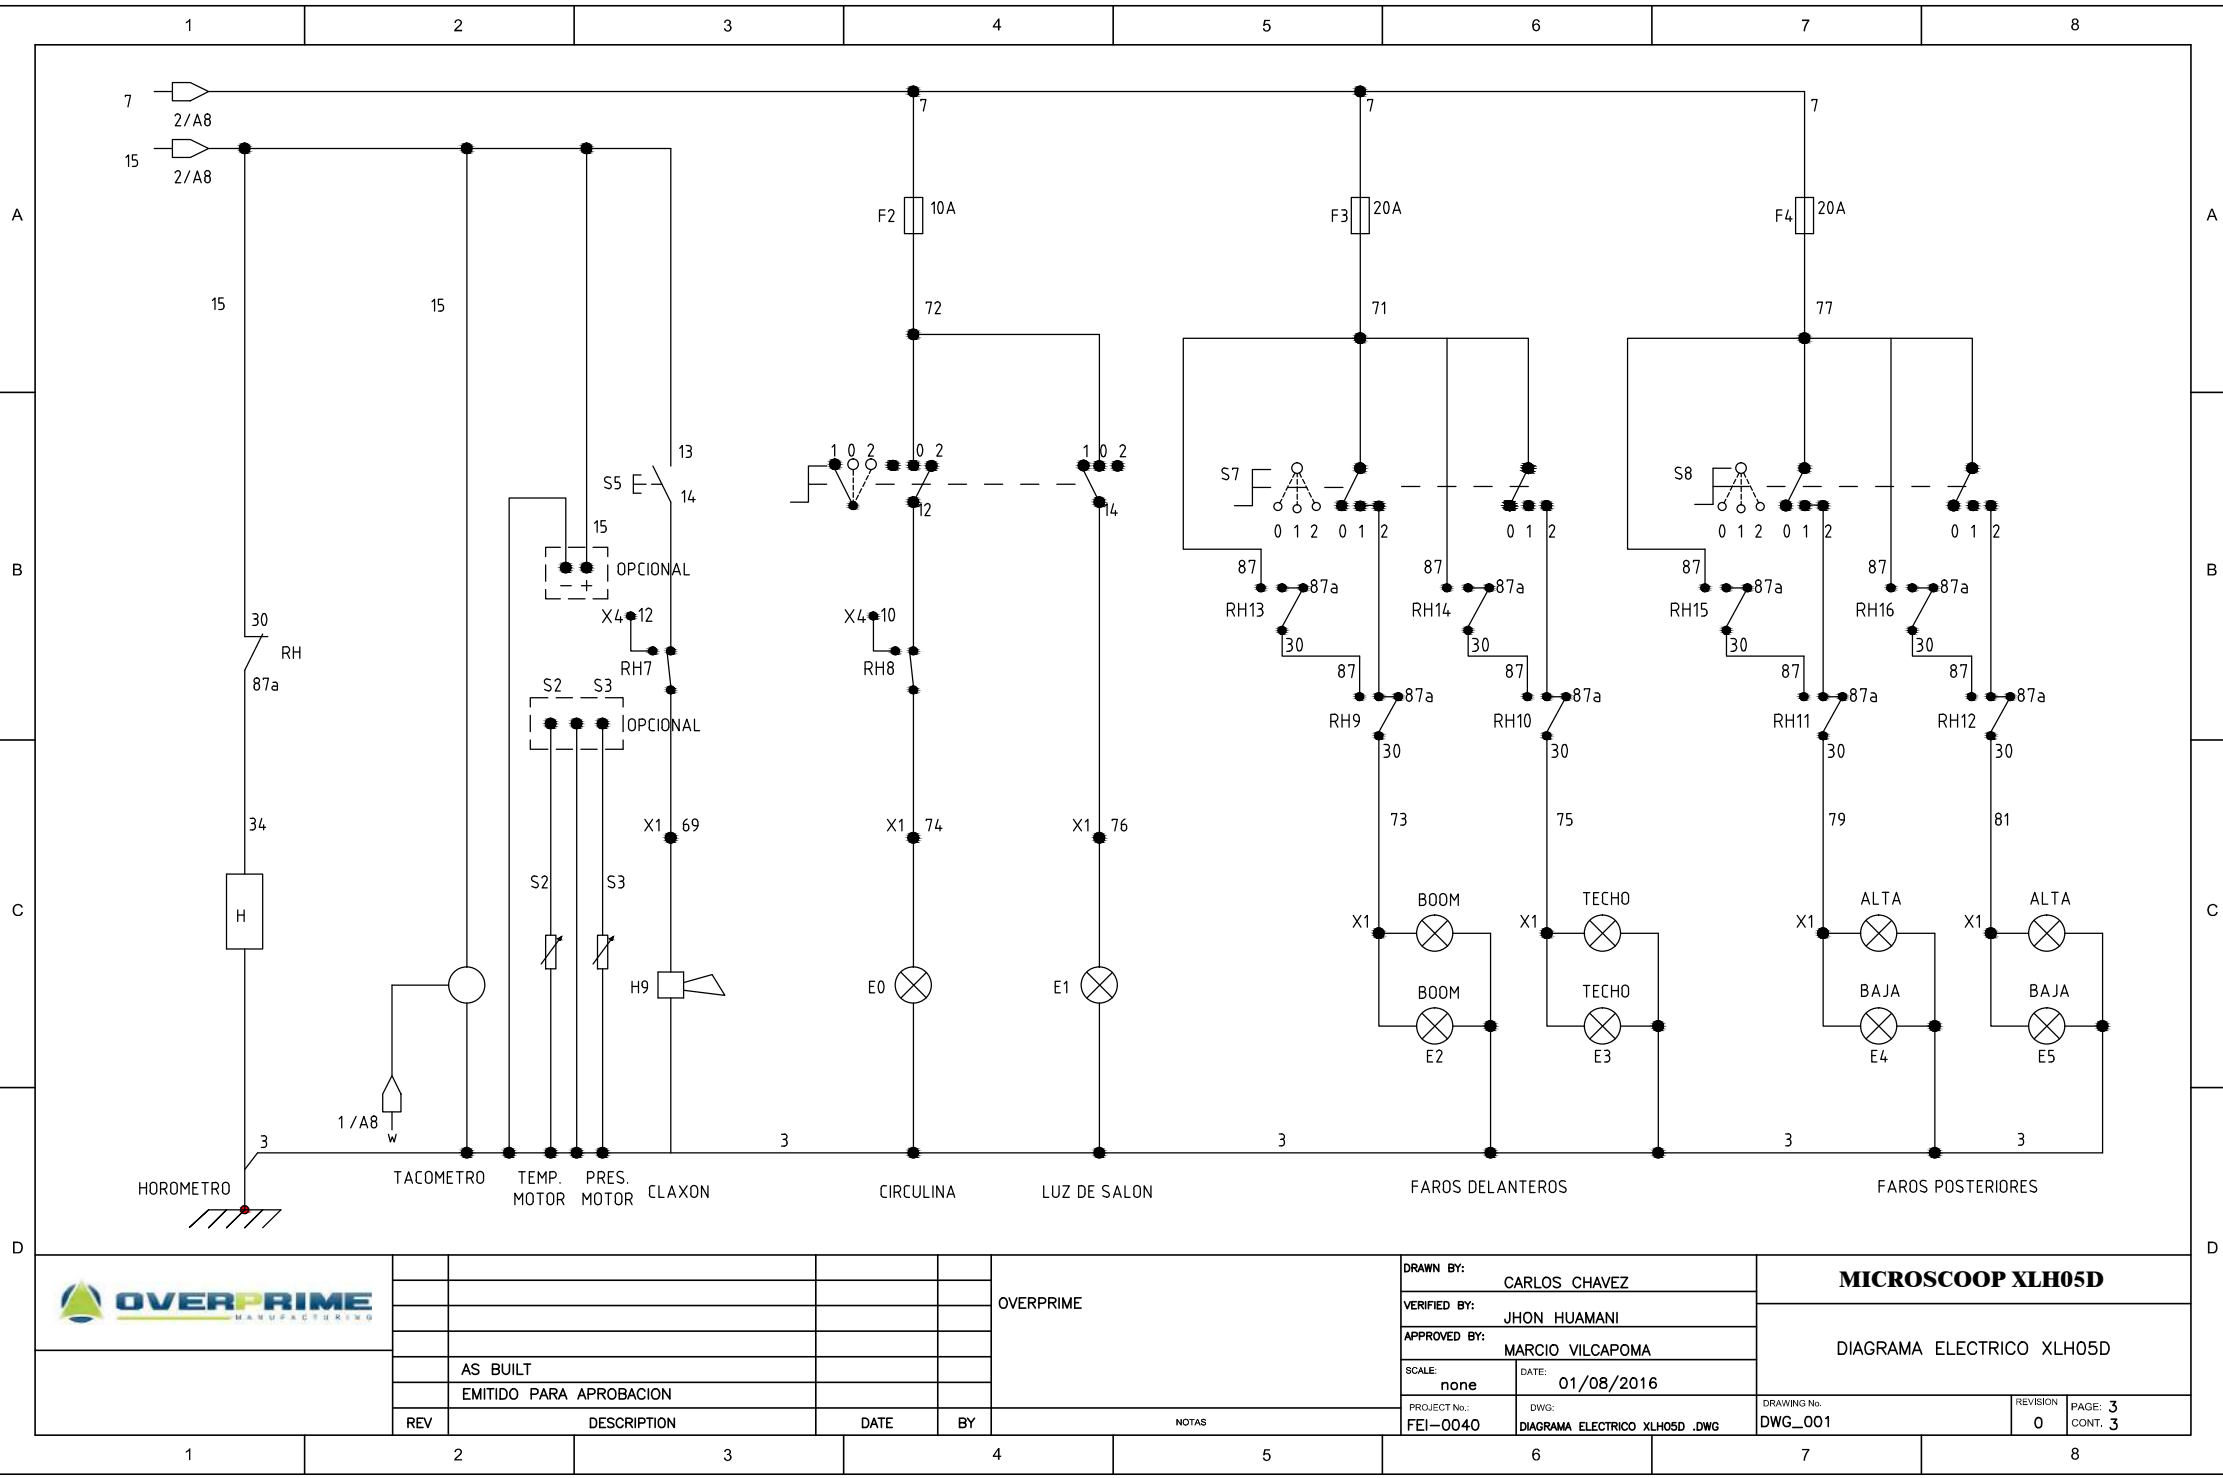



[www.overprimegroup.com](http://www.overprimegroup.com)